

# OTTAWA COUNTY ENGINEERS OFFICE

REFERENCE NO. 1-7-13-D  
WEST QUARTER POST SEC. 1  
ALLEN TWP.  
SHEET 1 OF 1.

PERSONNEL:  
M. WITTMAN, P.S.  
J. ALLEN  
K. BECK

DATE / WEATHER / TEMP:  
AUGUST 9, 2010  
SUNNY - S  
80° F

ROUTE: T-214 OPFER LENTZ RD.

TOWNSHIP: ALLEN


SECTION: 1

T 7 NR 13 E.

NORTHING:

EASTING:

DATUM:

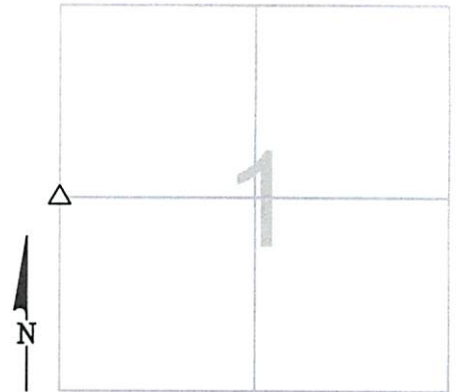

## MONUMENT INFORMATION

MONUMENT TYPE: FD. 6" x 6" POINTED HARDHEAD  
ON SURFACE - BELOW: 1.08'  
LEFT - CL PAV'T - RIGHT: 3.00'

STONE HAD FAINT DRILL HOLE

USED DRILL HOLE



## MISC. INFORMATION

FD. IRON BOLT ON SURFACE PER COUNTY  
RECORDS. TIED BOLT DOWN WITH X-TIES AND DUG  
FOR STONE. IRON BOLT WAS 0.11' WEST AND 0.11'  
NORTH OF DRILL HOLE IN STONE.

AUGUST 9, 2010

SET 1" SQUARE IRON PIN  
IN MONUMENT BOX OVER  
STONE

