

OTTAWA COUNTY ENGINEERS OFFICE

REFERENCE NO. 1-7-13-G
SW CORNER POST SECTION 1
ALLEN TWP.
SHEET 1 OF 1.

ROUTE: T-68 WALBRIDGE EAST RD.
@ T-214 OPFER LENTZ RD.

TOWNSHIP: ALLEN

SECTION: 1

T 7 N R 13 E.


NORTHING:

EASTING:

DATUM:

PERSONNEL:
M. WITTMAN, P.S.
J. ALLEN
K. BECK

DATE / WEATHER / TEMP:
AUGUST 6, 2010
SUNNY
76° F

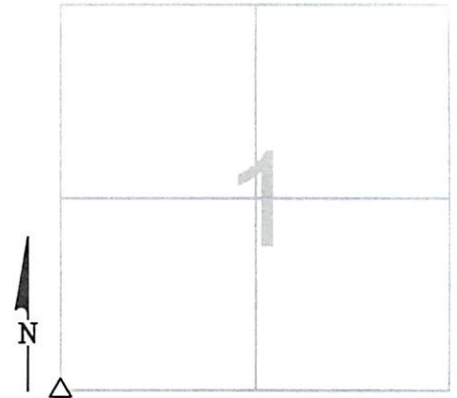

MONUMENT INFORMATION

MONUMENT TYPE: FD. 13" x 15-1/2" HARDHEAD
STONE W/ DRILL HOLE
ON SURFACE - BELOW: 1.55'
LEFT - CL PAV'T - RIGHT: 2.90'

USED DRILL HOLE



MISC. INFORMATION

FD. 3/4" IRON PIPE 0.13' BELOW SURFACE PER D.J.
NISSEN SURVEY DATED 9-14-1965. TIED WITH
X-TIES AND DUG FOR STONE. PIPE WAS 0.09' W
AND 0.04' NORTH OF DRILL HOLE.

AUGUST 6, 2010

SET 1" SQUARE IRON PIN
IN MONUMENT BOX OVER
STONE

