

OTTAWA COUNTY ENGINEERS OFFICE

REFERENCE NO. 10-7-13-B
NORTH QUARTER POST SEC. 10
ALLEN TWP.
SHEET 1 OF 1.

ROUTE: T-68 WALBRIDGE EAST RD.

TOWNSHIP: ALLEN

SECTION: 10

T 7 NR 13 E.

PERSONNEL:

M. WITTMAN, P.S.
J. ALLEN, V. SZABO
J. DUSSEAU, M. HEINTZ
T. MARQUETTE


NORTHING:

EASTING:

DATE / WEATHER / TEMP:

JUNE 16, 2025
SUNNY
70° F - HUMID

DATUM:

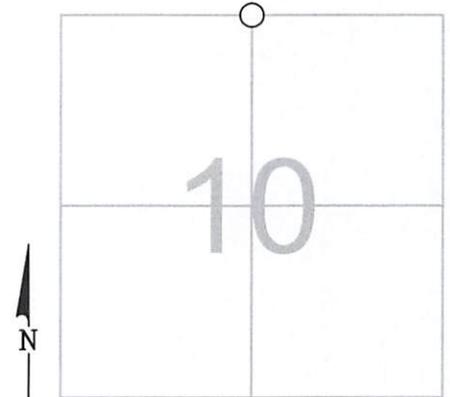

MONUMENT INFORMATION

MONUMENT TYPE: FD. 1-1/2" Ø IRON PIN
ON SURFACE - BELOW: 0.48'
LEFT - CL PAV'T - RIGHT: 4.30'



MISC. INFORMATION

IRON PIN IS OVER A 36" RCP CROSS-OVER UNDER WALBRIDGE EAST ROAD. CROSS-OVER WAS REPLACED IN OCTOBER 1983. THE CURRENT PIN WAS RESET BY P. BELL, P.E., P.S., G. FARROW AND M. BROUGH OF THIS OFFICE ON JUNE 26, 1984. SEE ALLEN TOWNSHIP 1972 FIELD BOOK PAGE 73.

JUNE 16, 2025

SET MONUMENT BOX OVER
FD. 1-1/2" Ø IRON PIN

