

# OTTAWA COUNTY ENGINEERS OFFICE

REFERENCE NO. 10-7-13-D  
W QUARTER POST SECTION 10  
ALLEN TWP.  
SHEET 1 OF 1.

ROUTE: C-51 GENOA CLAY CENTER RD.

TOWNSHIP: ALLEN

SECTION: 10

T 7 N R 13 E.

PERSONNEL:  
M. WITTMAN, P.S.  
M. BROUGH  
R. LAJTI, JR.


NORTHING:

EASTING:

DATUM:

DATE / WEATHER / TEMP:

JUNE 26, 2003  
CLDY  
70° F

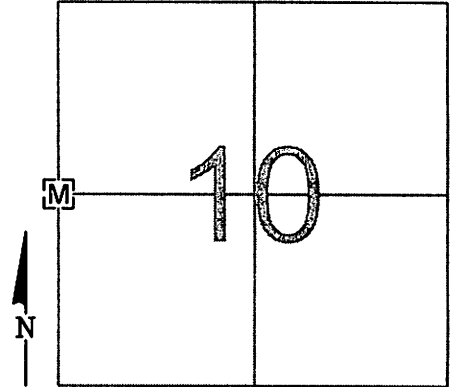

## MONUMENT INFORMATION

MONUMENT TYPE: FD 1" SQ. IRON PIN IN MON BOX  
ON SURFACE - BELOW:  
LEFT - CL PAVT - RIGHT:

## MISC. INFORMATION

1" SQ. IRON PIN 9-21-1971, MONUMENT BOX SET  
OVER PIN 9-23-1971

STATION 183+99.48 - 1962 C.R. #51 PLANS

PHOTO OF STONE NOT AVAILABLE

## SHORT TIES

SET PK NAIL N - 2.00'  
SET PK NAIL E - 2.00'  
SET PK NAIL S - 2.00'

