

# OTTAWA COUNTY ENGINEERS OFFICE

REFERENCE NO. 10-7-13-F  
EAST QUARTER POST SEC. 10  
ALLEN TWP.  
SHEET 1 OF 1.

ROUTE: T-7 MARTIN-WILLISTON RD.

TOWNSHIP: ALLEN

SECTION: 10

T 7 NR 13 E.


PERSONNEL:  
M. WITTMAN, P.S.  
J. ALLEN

NORTHING:

EASTING:

DATE / WEATHER / TEMP:  
AUGUST 30, 2021  
SUNNY - N  
78° F

DATUM:

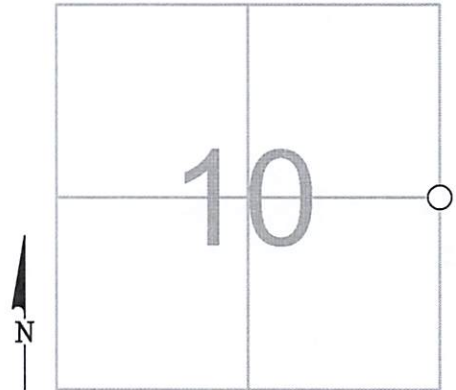

## MONUMENT INFORMATION

MONUMENT TYPE: FD. 5/8" IRON PIN  
ON SURFACE - BELOW: 0.12'  
LEFT - CL PAV'T - RIGHT: 1.51'



## MISC. INFORMATION

FD IRON PIN, TIED W/ X-TIES AND DUG FOR  
STONE. DUG 8" INTO CLAY AND PRODDED HOLE  
ANOTHER 2 FEET DOWN, DID NOT FIND STONE.

ACCEPTED IRON PIN DUE TO BEING OF RECORD.

AUGUST 30, 2021

SET 1" SQUARE IRON PIN  
IN MONUMENT BOX

