

OTTAWA COUNTY ENGINEERS OFFICE

REFERENCE NO. 10-7-13-I
SE CORNER POST SEC. 10
ALLEN TWP.
SHEET 1 OF 1.

ROUTE: T-7 MARTIN-WILLISTON RD.
@ T-67 TROWBRIDGE RD.

TOWNSHIP: ALLEN

SECTION: 10

T 7 NR 13 E.


NORTHING:

EASTING:

DATUM:

PERSONNEL:
M. WITTMAN, P.S.
J. ALLEN

DATE / WEATHER / TEMP:
OCTOBER 9, 2012
SUNNY - SE
47° F

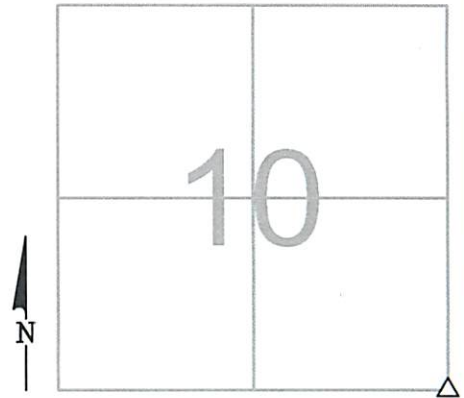

MONUMENT INFORMATION

MONUMENT TYPE: FD. BROKEN LIMESTONE
ON SURFACE - BELOW: 1.11'
LEFT - CL PAV'T - RIGHT: 5.0'

ORIGINAL SIZE OF STONE LOOKS TO BE 10" x 13"



MISC. INFORMATION

MAIN PART OF STONE IS INTACT, NE CORNER OF
STONE IS BROKEN OFF.

1-1/4" O.D. IRON PIPE FOUND 0.50' SOUTH AND 0.13"
WEST OF CENTER OF STONE.

USED CENTER OF STONE.

OCTOBER 9, 2012

SET 1" SQUARE IRON PIN
IN MONUMENT BOX OVER
STONE

SET DRILL HOLE
IN N. END
RCP X-OVER

TROWBRIDGE RD., T.R. #67

SET DRILL HOLE
IN S. END
RCP X-OVER

