

OTTAWA COUNTY ENGINEERS OFFICE

REFERENCE NO. 11-7-13-B
 NORTH QUARTER POST SEC. 11
 ALLEN TWP.
 SHEET 1 OF 1.

ROUTE: T-68 WALBRIDGE EAST RD.

TOWNSHIP: ALLEN

SECTION: 11


T 7 NR 13 E.

PERSONNEL:
 M. WITTMAN, P.S.
 J. ALLEN
 K. BECK

NORTHING:

EASTING:

DATUM:

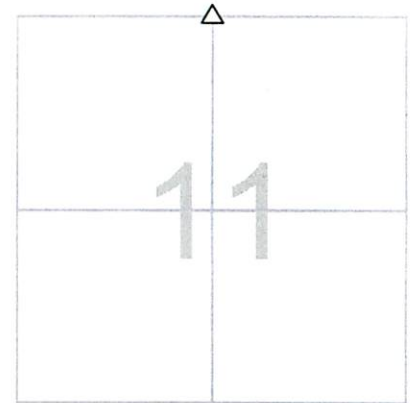

DATE / WEATHER / TEMP:
 AUGUST 6, 2010
 SUNNY
 72° F

MONUMENT INFORMATION

MONUMENT TYPE: FD. 7" x 10" STONE
 ON SURFACE - BELOW: 1.07'
 LEFT - CL PAV'T - RIGHT: 3.20'

DRILL HOLE IN STONE

USED DRILL HOLE



MISC. INFORMATION

AUGUST 6, 2010

SET 1" SQUARE IRON PIN
 IN MONUMENT BOX OVER
 STONE

