

OTTAWA COUNTY ENGINEERS OFFICE

REFERENCE NO. 11-7-13-F
 EAST QUARTER POST SEC. 11
 ALLEN TWP.
 SHEET 1 OF 1.

ROUTE: T-214 OPFER LENTZ RD.

TOWNSHIP: ALLEN

SECTION: 11


T 7 NR 13 E.

PERSONNEL:
 M. WITTMAN, P.S.
 J. ALLEN
 K. BECK

NORTHING:

EASTING:

DATUM:

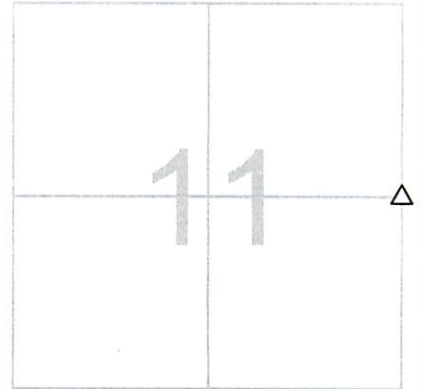

DATE / WEATHER / TEMP:
 AUGUST 2, 2010
 SUNNY - HUMID
 84° F

MONUMENT INFORMATION

MONUMENT TYPE: FD. 11" x 7" POINTED HARDHEAD
 STONE - RECTANGULAR
 ON SURFACE - BELOW: 1.20'
LEFT - CL PAV'T - RIGHT: 4.10'

 USED HIGH POINT ON EAST END OF STONE.



MISC. INFORMATION

AUGUST 2, 2010

SET 1" SQUARE IRON PIN
 IN MONUMENT BOX OVER
 STONE

