

# OTTAWA COUNTY ENGINEERS OFFICE

REFERENCE NO. 11-7-13-G  
SW CORNER POST SEC. 11  
ALLEN TWP.  
SHEET 1 OF 1.

ROUTE: T-7 MARTIN-WILLISTON RD.  
@ T-67 TROWBRIDGE RD.

TOWNSHIP: ALLEN

SECTION: 11

T 7 NR 13 E.


NORTHING:

EASTING:

DATUM:

PERSONNEL:  
M. WITTMAN, P.S.  
J. ALLEN

DATE / WEATHER / TEMP:  
OCTOBER 9, 2012  
SUNNY - SE  
47° F

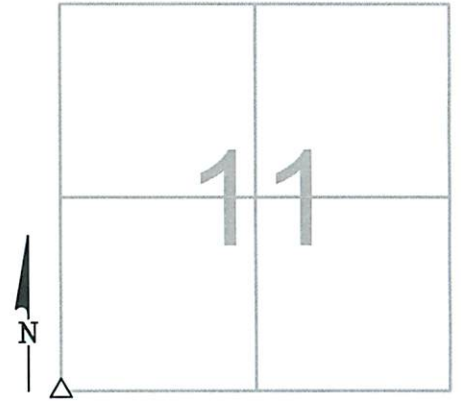

## MONUMENT INFORMATION

MONUMENT TYPE: FD. BROKEN LIMESTONE  
ON SURFACE - BELOW: 1.11'  
LEFT - CL PAV'T - RIGHT: 5.0'

ORIGINAL SIZE OF STONE LOOKS TO BE 10" x 13"



## MISC. INFORMATION

MAIN PART OF STONE IS INTACT, NE CORNER OF  
STONE IS BROKEN OFF.

1-1/4" O.D. IRON PIPE FOUND 0.50' SOUTH AND 0.13'  
WEST OF CENTER OF STONE.

USED CENTER OF STONE.

OCTOBER 9, 2012

SET 1" SQUARE IRON PIN  
IN MONUMENT BOX OVER  
STONE

