

# OTTAWA COUNTY ENGINEERS OFFICE

REFERENCE NO. 12-7-13-C  
NE CORNER POST SECTION 12  
ALLEN TWP.  
SHEET 1 OF 1.

ROUTE: C-213 NISSEN RD.  
@ T-68 WALBRIDGE EAST RD.

TOWNSHIP: ALLEN

SECTION: 12

T 7 NR 13 E.


NORTHING:

EASTING:

DATUM:

PERSONNEL:  
M. WITTMAN, P.S.  
J. ALLEN

DATE / WEATHER / TEMP:  
JULY 29, 2014  
SUNNY  
67° F

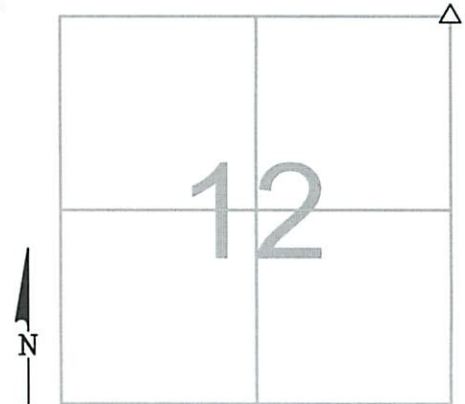

## MONUMENT INFORMATION

MONUMENT TYPE: FD. 10" X 5" OVAL HARDHEAD STONE  
ON SURFACE - BELOW: 2.11'  
LEFT - CL PAV'T - RIGHT: 1.50'  
  
USED CENTER OF STONE.



## MISC. INFORMATION

FD. RR SPIKE 0.12' BELOW SURFACE, TIED W/ GPS AND  
DUG FOR IRON PIN OF RECORD. FD. PAVING BRICK SET  
BY R.C. STEINMILLER 0.20' ABOVE STONE. DID NOT  
FIND IRON PIN. RR SPIKE WAS 0.02' WEST AND 0.01'  
SOUTH OF CENTER OF STONE

JULY 29, 2014

SET 1" SQUARE IRON PIN  
IN MONUMENT BOX OVER  
STONE

