

OTTAWA COUNTY ENGINEERS OFFICE

REFERENCE NO. 12-7-13-H
SOUTH QUARTER POST SEC. 12
ALLEN TWP.
SHEET 1 OF 1.

PERSONNEL:
M. WITTMAN, P.S.
J. ALLEN

DATE / WEATHER / TEMP:
JULY 6, 2015
SUNNY - N
81° F

ROUTE: T-67 TROWBRIDGE RD.

TOWNSHIP: ALLEN


SECTION: 12

T 7 NR 13 E.

NORTHING:

EASTING:

DATUM:

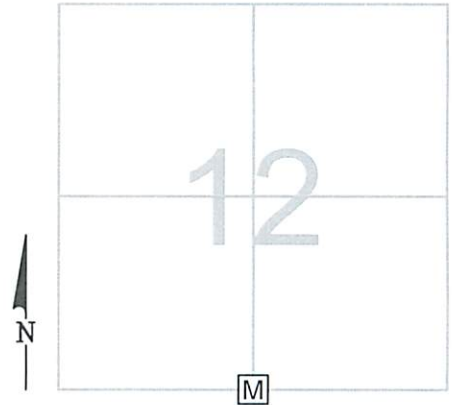

MONUMENT INFORMATION

MONUMENT TYPE: SET 1" SQ. IRON PIN IN MON BOX
ON SURFACE - BELOW:
LEFT - CL PAV'T - RIGHT: 0.40'



MISC. INFORMATION

FD. RR SPK ON SURFACE, TIED W/ X-TIES AND DUG FOR STONE. FOUND OLD ASPHALT ROAD SURFACE AT 17" DOWN, NO EVIDENCE FOUND. DUG A TOTAL OF 36" DOWN INTO CLAY AND FOUND NOTHING, USED LOCATION OF FD RR SPK AND SET 1" SQ. IRON PIN IN MONUMENT BOX.

JULY 6, 2015

SET 1" SQUARE IRON PIN
IN MONUMENT BOX

