

OTTAWA COUNTY ENGINEERS OFFICE

REFERENCE NO. 12-7-13-I
 SE CORNER POST SEC. 12
 ALLEN TWP.
 SHEET 1 OF 1.

ROUTE: C-213 NISSEN RD.
 @ T-67 TROWBRIDGE RD.

TOWNSHIP: ALLEN


SECTION: 12

T 7 N R 13 E.

NORTHING:

EASTING:

DATUM:

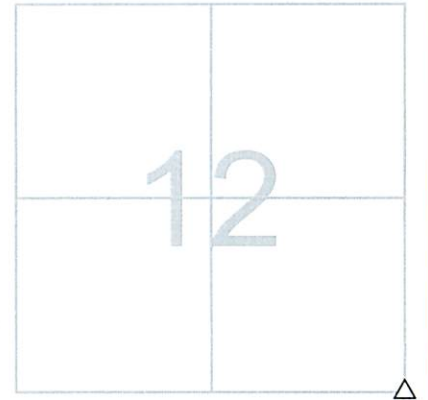

PERSONNEL:
 M. WITTMAN, P.S.
 J. ALLEN

DATE / WEATHER / TEMP:
 JULY 8, 2015
 PTLY SUNNY - N / NE
 68° F

MONUMENT INFORMATION

MONUMENT TYPE: FD. 11" X 11" TRIANGULAR LIMESTONE
 ON SURFACE - BELOW: 1.67'
LEFT - CL PAV'T - RIGHT: 3.80'
 USED CENTER OF STONE.



MISC. INFORMATION

FD MAG NAIL 0.03' BELOW SURFACE, TIED W/ X-TIES
 AND DUG FOR STONE. FD RR SPK 0.85' BELOW
 SURFACE, RR SPK WAS DIRECTLY BELOW SURFACE
 MAG NAIL. SURFACE MAG NAIL AND RR SPK WERE
 0.21' SOUTH AND 0.08' EAST OF CENTER OF STONE.

JULY 8, 2015

SET 1" SQUARE IRON PIN
 IN MONUMENT BOX OVER
 STONE

