

# OTTAWA COUNTY ENGINEERS OFFICE

REFERENCE NO. 13-7-13-B  
NORTH QUARTER POST SEC. 13  
ALLEN TWP.  
SHEET 1 OF 1.

ROUTE: T-67 TROWBRIDGE RD.

TOWNSHIP: ALLEN

SECTION: 13

T 7 NR 13 E.

**PERSONNEL:**

M. WITTMAN, P.S.  
J. ALLEN


NORTHING:

EASTING:

**DATE / WEATHER / TEMP:**

JULY 6, 2015  
SUNNY - N  
81° F

DATUM:

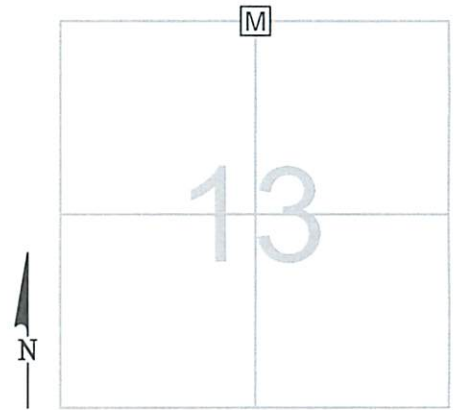

MONUMENT INFORMATION

MONUMENT TYPE: SET 1" SQ. IRON PIN IN MON BOX  
ON SURFACE - BELOW:  
LEFT - CL PAV'T - RIGHT: 0.40'



MISC. INFORMATION

FD. RR SPK ON SURFACE, TIED W/ X-TIES AND DUG FOR STONE. FOUND OLD ASPHALT ROAD SURFACE AT 17" DOWN, NO EVIDENCE FOUND. DUG A TOTAL OF 36" DOWN INTO CLAY AND FOUND NOTHING, USED LOCATION OF FD RR SPK AND SET 1" SQ. IRON PIN IN MONUMENT BOX.

JULY 6, 2015

SET 1" SQUARE IRON PIN  
IN MONUMENT BOX

