


# OTTAWA COUNTY ENGINEERS OFFICE

REFERENCE NO. 13-7-13-D  
 WEST QUARTER POST SEC. 13  
 ALLEN TWP.  
 SHEET 1 OF 1.

ROUTE: T-214 OPFER-LENTZ RD.  
 TOWNSHIP: ALLEN  
 SECTION: 13  
 T 7 NR 13 E.

PERSONNEL:  
 M. WITTMAN, P.S.  
 J. ALLEN

NORTHING:  
 EASTING:  
 DATUM:

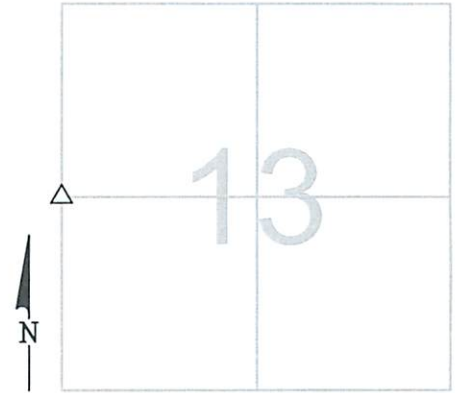

DATE / WEATHER / TEMP:  
 JULY 6, 2015  
 SUNNY  
 73° F

### MONUMENT INFORMATION

MONUMENT TYPE: FD. 9"x9" LIMESTONE  
 ON SURFACE - BELOW: 1.05'  
LEFT - CL PAV'T - RIGHT: 4.0'

FD WOODEN STAKE ON NORTH SIDE OF STONE  
 USED CENTER OF STONE



### MISC. INFORMATION

FD RR SPK ON SURFACE, TIED W/ X-TIES AND  
 DUG FOR STONE. RR SPK WAS 1.00' SOUTH AND  
 0.44' WEST OF CENTER OF STONE.

JULY 6, 2015

SET 1" SQUARE IRON PIN  
 IN MONUMENT BOX OVER  
 STONE

