

OTTAWA COUNTY ENGINEERS OFFICE

REFERENCE NO. 13-7-13-F
EAST QUARTER POST SEC. 13
ALLEN TWP.
SHEET 1 OF 1.

ROUTE: C-213 NISSEN RD.

TOWNSHIP: ALLEN

SECTION: 13

T 7 NR 13 E.


NORTHING:

EASTING:

DATUM:

PERSONNEL:
M. WITTMAN, P.S.
J. ALLEN

DATE / WEATHER / TEMP:
MAY 22, 2012
OVERCAST N-NE
62° F

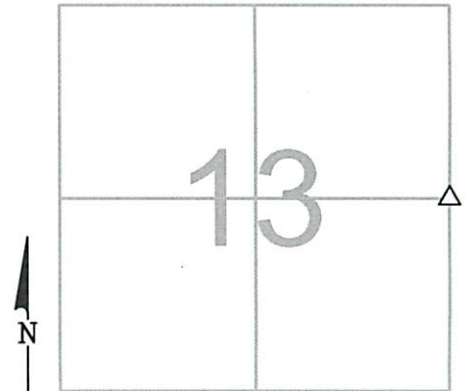

MONUMENT INFORMATION

MONUMENT TYPE: FD. 9" X 10" HARDHEAD STONE
ON SURFACE - BELOW: 1.26'
LEFT - CL PAV'T - RIGHT: 4.15'

RECTANGULAR STONE

USED SMALL HOLE IN DEPRESSION OF STONE



MISC. INFORMATION

FD. MAG NAIL ON SURFACE W/ 2'-0" TIES N, S & E.
TIED W/ X-TIES AND DUG FOR STONE. PK FOUND
MATCHED POINT USED ON STONE.

MAY 22, 2012

SET 1" SQUARE IRON PIN
IN MONUMENT BOX OVER
STONE

