

OTTAWA COUNTY ENGINEERS OFFICE

REFERENCE NO. 14-7-13-C
 NE CORNER POST SEC. 14
 ALLEN TWP.
 SHEET 1 OF 1.

PERSONNEL:
 M. WITTMAN, P.S.
 J. ALLEN

DATE / WEATHER / TEMP:
 AUGUST 20, 2015
 SUNNY - SW
 68° F

ROUTE: T-213 OPFER-LENTZ RD.
 @ T- 67 TROWBRIDGE RD.

TOWNSHIP: ALLEN


SECTION: 14

T 7 NR 13 E.

NORTHING:


EASTING:

DATUM:

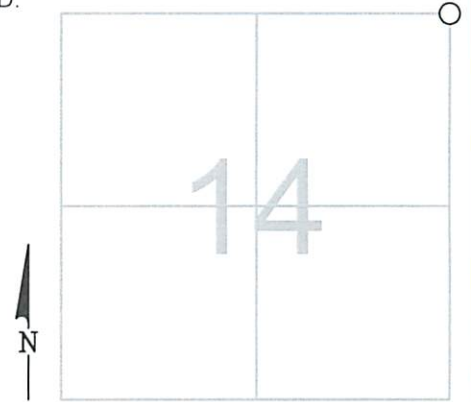

MONUMENT INFORMATION

MONUMENT TYPE: SET 1" SQ. IRON PIN IN MON BOX
ON SURFACE - BELOW:
LEFT - CL PAV'T - RIGHT: 6.00' (OPFER-LENTZ RD)

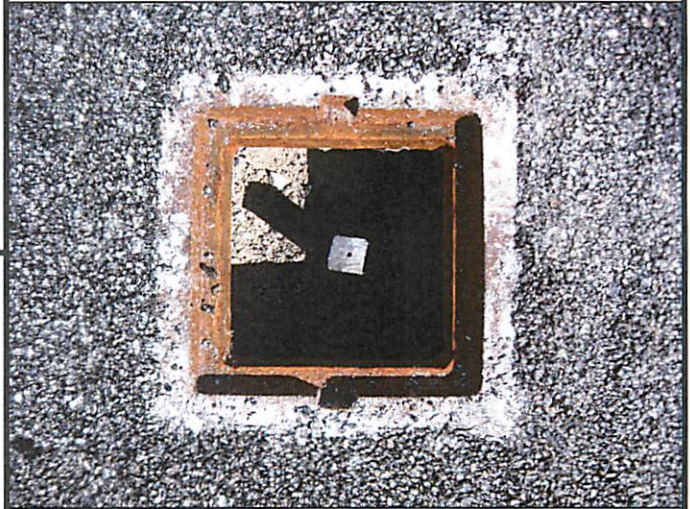

MISC. INFORMATION

FD. RR SPK ON SURFACE, TIED W/ X-TIES AND
 DUG FOR STONE. DID NOT FIND A STONE. USED
 LOCATION OF RR SPK AND SET 1" SQ. IRON PIN
 IN A MONUMENT BOX.

AUGUST 20, 2015

SET 1" SQUARE IRON PIN
 IN MONUMENT BOX

