

# OTTAWA COUNTY ENGINEERS OFFICE

**REFERENCE NO.** 14-7-13-D  
 WEST QUARTER POST SEC. 14  
 ALLEN TWP.

**SHEET** 1 OF 1.

**PERSONNEL:**  
 M. WITTMAN, P.S.  
 J. ALLEN

**DATE / WEATHER / TEMP:**  
 OCTOBER 9, 2012  
 SUNNY - SE  
 56° F

**ROUTE:** T-7 MARTIN-WILLISTON RD.

**TOWNSHIP:** ALLEN


**SECTION:** 14

**T** 7 **NR** 13 **E.**

**NORTHING:**

**EASTING:**

**DATUM:**

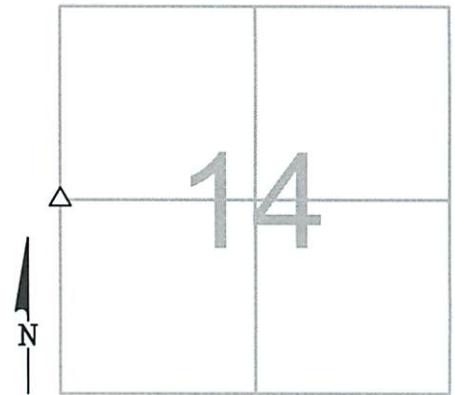

### MONUMENT INFORMATION

MONUMENT TYPE: FD. HARDHEAD STONE  
 ON SURFACE - BELOW: 1.06'  
LEFT - CL PAV'T - RIGHT: 9.0'

5"x 4"x8" HARDHEAD STONE



### MISC. INFORMATION

FD. 5/8" IRON PIN 0.05' WEST OF EOP IN BERM, TIED WITH X-TIES AND DUG FOR STONE.  
 FD. 6"x5"x8" WEDGE SHAPED PILOT STONE UNDER 5/8" IRON PIN. IRON PIN WAS BENT  
 TO FIT OVER STONE. PRODDED AROUND AND UNDER PILOT STONE AND HIT ANOTHER  
 STONE. PULLED PILOT STONE AND FOUND STONE REFERENCED ABOVE. 5/8" IRON PIN  
 WAS 0.15' NORTH OF CENTER OF PILOT STONE. FD. STONE WAS 5" N/S AND 4" E/W  
 WITH HIGH RIDGE RUNNING N/S, USED CENTER OF HIGH RIDGE. 5/8" IRON PIN WAS  
 0.25' WEST AND 0.21' NORTH OF POINT USED ON HIGH RIDGE OF STONE.

OCTOBER 9, 2012

SET 1" SQUARE IRON PIN  
 IN MONUMENT BOX OVER  
 STONE

