

OTTAWA COUNTY ENGINEERS OFFICE

REFERENCE NO. 14-7-13-G
 SW CORNER POST SEC. 14
 ALLEN TWP.
 SHEET 1 OF 1.

ROUTE: T-7 MARTIN-WILLISTON RD.

TOWNSHIP: ALLEN

SECTION: 14


T 7 NR 13 E.

PERSONNEL:
 M. WITTMAN, P.S.
 J. ALLEN

NORTHING:

EASTING:

DATUM:

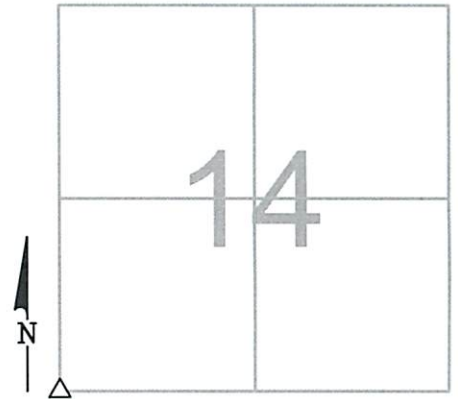

DATE / WEATHER / TEMP:

OCTOBER 8, 2012
 SUNNY - SW
 50° F

MONUMENT INFORMATION


MONUMENT TYPE: FD. HARDHEAD STONE W/ DH
 ON SURFACE - BELOW: 1.73'
LEFT - CL PAV'T - RIGHT: 3.70'

IRREGULAR SHAPED STONE 8" N/S x 6" E/W



MISC. INFORMATION

FD. RAILROAD SPIKE 0.10' BELOW SURFACE TIED
 W/ X-TIES AND DUG FOR STONE. RAILROAD SPIKE
 FIT DH IN STONE.

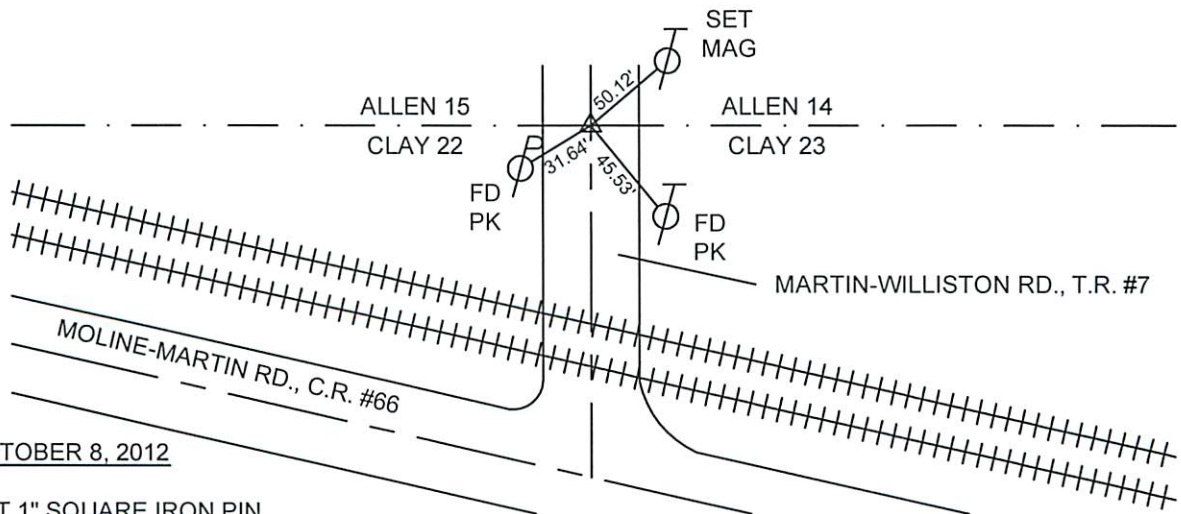

OCTOBER 8, 2012

SET 1" SQUARE IRON PIN
 IN MONUMENT BOX OVER
 STONE