

# OTTAWA COUNTY ENGINEERS OFFICE

REFERENCE NO. 14-7-13-H  
SOUTH QUARTER POST SEC. 14  
ALLEN TWP.  
SHEET 1 OF 1.

ROUTE: C-66 MOLINE-MARTIN RD.

TOWNSHIP: ALLEN

SECTION: 14

T 7 NR 13 E.

**PERSONNEL:**

M. WITTMAN, P.S.  
J. ALLEN  
M. ULLRICH  
S. ULLRICH


NORTHING:

EASTING:

DATUM:

**DATE / WEATHER / TEMP:**

SEPTEMBER 5, 2008  
OVERCAST MISTY  
72° F

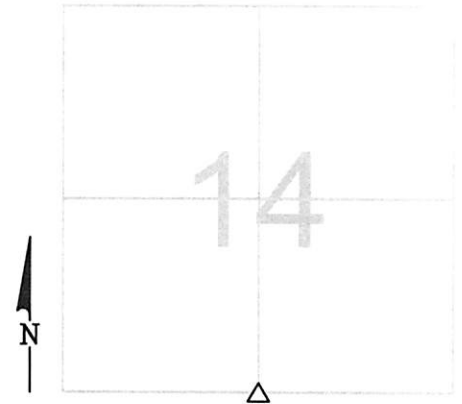

MONUMENT INFORMATION

MONUMENT TYPE: FD. GRAY HARDHEAD STONE  
W/ NOTCH ON TOP RIDGE: USED CENTER OF NOTCH  
ON SURFACE - BELOW: 1.88'  
LEFT - CL PAV'T - RIGHT: 0.50'  
  
STONE=4" X 5" x 7"



MISC. INFORMATION

SEPTEMBER 5, 2008

SET 1" SQUARE IRON PIN  
IN MONUMENT BOX OVER  
STONE

