

OTTAWA COUNTY ENGINEERS OFFICE

REFERENCE NO. 15-7-13-C
NE CORNER POST SEC. 15
ALLEN TWP.
SHEET 1 OF 1.

ROUTE: T-7 MARTIN-WILLISTON RD.
@ T-67 TROWBRIDGE RD.

TOWNSHIP: ALLEN

SECTION: 15

T 7 NR 13 E.


NORTHING:

EASTING:

DATUM:

PERSONNEL:
M. WITTMAN, P.S.
J. ALLEN

DATE / WEATHER / TEMP:
OCTOBER 9, 2012
SUNNY - SE
47° F

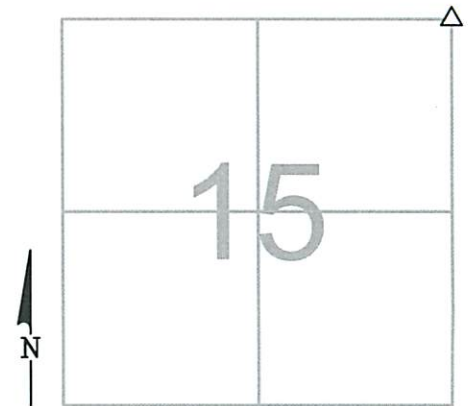

MONUMENT INFORMATION

MONUMENT TYPE: FD. BROKEN LIMESTONE
ON SURFACE - BELOW: 1.11'
LEFT - CL PAV'T - RIGHT: 5.0'

ORIGINAL SIZE OF STONE LOOKS TO BE 10" x 13"



MISC. INFORMATION

MAIN PART OF STONE IS INTACT, NE CORNER OF
STONE IS BROKEN OFF.

1-1/4" O.D. IRON PIPE FOUND 0.50' SOUTH AND 0.13'
WEST OF CENTER OF STONE.

USED CENTER OF STONE.

OCTOBER 9, 2012

SET 1" SQUARE IRON PIN
IN MONUMENT BOX OVER
STONE

