

OTTAWA COUNTY ENGINEERS OFFICE

REFERENCE NO. 15-7-13-D
WEST QUARTER POST SEC. 15
ALLEN TWP.
SHEET 1 OF 1.

ROUTE: C-51 GENOA-CLAY CENTER RD.

TOWNSHIP: ALLEN

SECTION: 15

T 7 NR 13 E.

PERSONNEL:
M. WITTMAN, P.S.
J. ALLEN


NORTHING:

EASTING:

DATUM:

DATE / WEATHER / TEMP:

OCTOBER 23, 2008
SUNNY S-SE
57° F

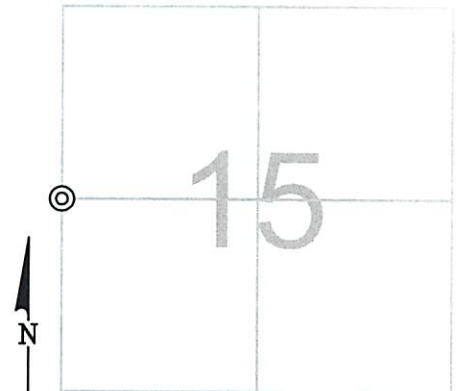

MONUMENT INFORMATION

MONUMENT TYPE: FD. 1 1/4" O.D. IRON PIPE WITH
PK NAIL-PER 1979 C.R. #51 PLANS
ON SURFACE - BELOW: 0.43'
LEFT - CL PAV'T - RIGHT: 2.50'



MISC. INFORMATION

OCTOBER 23, 2008

SET MONUMENT BOX OVER
IRON PIPE

