


OTTAWA COUNTY ENGINEERS OFFICE

REFERENCE NO. 15-7-13-F
 EAST QUARTER POST SEC. 15
 ALLEN TWP.
 SHEET 1 OF 1.

ROUTE: T-7 MARTIN-WILLISTON RD.
 TOWNSHIP: ALLEN
 SECTION: 15
 T 7 NR 13 E.

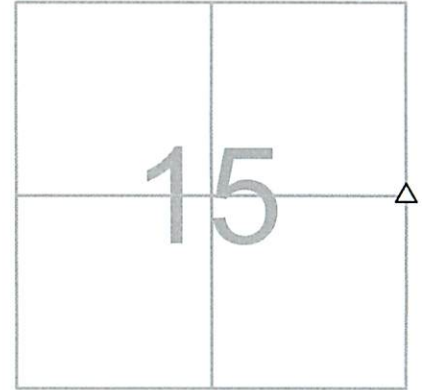

PERSONNEL:
 M. WITTMAN, P.S.
 J. ALLEN

NORTHING:

EASTING:

DATE / WEATHER / TEMP:
 OCTOBER 9, 2012
 SUNNY - SE
 56° F

DATUM:

MONUMENT INFORMATION

MONUMENT TYPE: FD. HARDHEAD STONE
 ON SURFACE - BELOW: 1.06'
LEFT - CL PAV'T - RIGHT: 9.0'

 5"x 4"x8" HARDHEAD STONE



MISC. INFORMATION

FD. 5/8" IRON PIN 0.05' WEST OF EOP IN BERM, TIED WITH X-TIES AND DUG FOR STONE.
 FD. 6"x5"x8" WEDGE SHAPED PILOT STONE UNDER 5/8" IRON PIN. IRON PIN WAS BENT
 TO FIT OVER STONE. PRODDED AROUND AND UNDER PILOT STONE AND HIT ANOTHER
 STONE. PULLED PILOT STONE AND FOUND STONE REFERENCED ABOVE. 5/8" IRON PIN
 WAS 0.15' NORTH OF CENTER OF PILOT STONE. FD. STONE WAS 5" N/S AND 4" E/W
 WITH HIGH RIDGE RUNNING N/S, USED CENTER OF HIGH RIDGE. 5/8" IRON PIN WAS
 0.25' WEST AND 0.21' NORTH OF POINT USED ON HIGH RIDGE OF STONE.

OCTOBER 9, 2012

SET 1" SQUARE IRON PIN
 IN MONUMENT BOX OVER
 STONE

