

OTTAWA COUNTY ENGINEERS OFFICE

REFERENCE NO. 15-7-13-G
SW CORNER SECTION 15
ALLEN TWP.
SHEET 1 OF 1.

ROUTE: C-51 GENOA-CLAY CENTER RD.
@ T-66 MOLINE MARTIN RD.

TOWNSHIP: ALLEN

SECTION: 15

T 7 NR 13 E.

NORTHING:

EASTING:

DATUM:


PERSONNEL:
M. WITTMAN, P.S.
J. ALLEN

DATE / WEATHER / TEMP:
OCTOBER 2, 2008
OVERCAST W
57° F



MONUMENT INFORMATION

MONUMENT TYPE: FD. 1" SQUARE IRON PIN IN
MONUMENT BOX
ON SURFACE - BELOW: 0.52'
LEFT - CL PAV'T - RIGHT: 0.62'

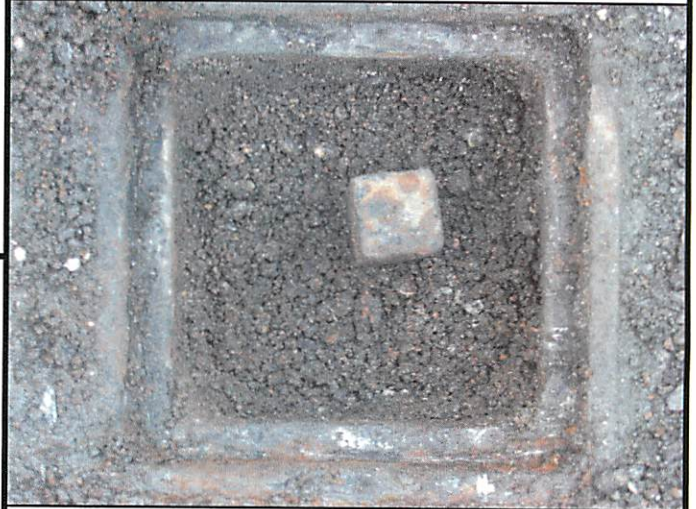

MISC. INFORMATION

