

OTTAWA COUNTY ENGINEERS OFFICE

REFERENCE NO. 15-7-13-I
SE CORNER POST SEC. 15
ALLEN TWP.

SHEET 1 OF 1.

PERSONNEL:
M. WITTMAN, P.S.
J. ALLEN

DATE / WEATHER / TEMP:
OCTOBER 8, 2012
SUNNY - SW
50° F

ROUTE: T-7 MARTIN-WILLISTON RD.

TOWNSHIP: ALLEN


SECTION: 15

T 7 NR 13 E.

NORTHING:

EASTING:

DATUM:

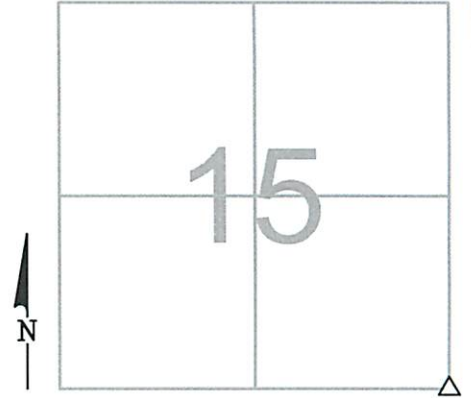

MONUMENT INFORMATION

MONUMENT TYPE: FD. HARDHEAD STONE W/ DH
ON SURFACE - BELOW: 1.73'
LEFT - CL PAV'T - RIGHT: 3.70'

IRREGULAR SHAPED STONE 8" N/S x 6" E/W



MISC. INFORMATION

FD. RAILROAD SPIKE 0.10' BELOW SURFACE TIED
W/ X-TIES AND DUG FOR STONE. RAILROAD SPIKE
FIT DH IN STONE.

