

# OTTAWA COUNTY ENGINEERS OFFICE

**REFERENCE NO.** 16-7-13-A  
 NW CORNER SECTION 16  
 ALLEN TWP.  
**SHEET** 1 OF 1.

**ROUTE:** T-53 REIMAN RD.  
 @ T-67 TROWBRIDGE RD.

**TOWNSHIP:** ALLEN

**SECTION:** 16

**T** 7 **NR** 13 **E.**

**NORTHING:**

**EASTING:**

**DATUM:**




**PERSONNEL:**  
 M. WITTMAN, P.S.  
 J. ALLEN  
 S. ULLRICH

**DATE / WEATHER / TEMP:**  
 AUGUST 26, 2008  
 SUNNY E  
 74° F

### MONUMENT INFORMATION

MONUMENT TYPE: FD. 1"X 2" RECTANGULAR  
 IRON PIN IN MONUMENT BOX  
 ON SURFACE - BELOW: 0.25'  
LEFT - CL PAV'T - RIGHT: 4.0' REIMAN RD.

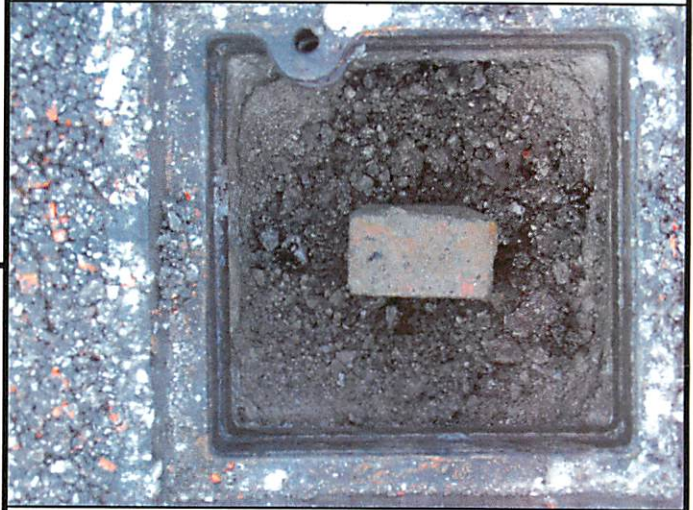

### MISC. INFORMATION

  
 USED CENTER  
 OF PIN

