

OTTAWA COUNTY ENGINEERS OFFICE

REFERENCE NO. 16-7-13-E
CENTER POST SEC. 16
ALLEN TWP.
SHEET 1 OF 1.

ROUTE: C-59 BOLANDER RD.

TOWNSHIP: ALLEN

SECTION: 16

T 7 NR 13 E.


NORTHING:

EASTING:

DATUM:

PERSONNEL:
M. WITTMAN, P.S.
J. ALLEN
V. SZABO

DATE / WEATHER / TEMP:
MAY 3, 2017
SUNNY - N
60° F

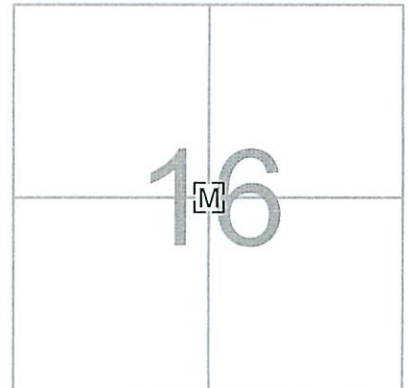

MONUMENT INFORMATION

MONUMENT TYPE: FD. 7/8" Ø IRON PIN IN MON BOX
ON SURFACE - BELOW: 0.74'
LEFT - CL PAVT - RIGHT:



MISC. INFORMATION

MAY 3, 2017

SET MONUMENT BOX OVER FD.
7/8" IRON PIN IN MONUMENT BOX

