OTTAWA COUNTY ENGINEERS OFFICE

REFERENCE NO. 17-7-13-A NW CORNER POST SEC. 17

ALLEN TWP. SHEET 1 OF 1. ROUTE: T-67 TROWBRIDGE RD. @ T-54 BILLMAN RD.

TOWNSHIP: ALLEN

SECTION: 17

PERSONNEL: M. WITTMAN, P.S.

J. ALLEN

T 7 NR 13 E.


NORTHING:

EASTING:

DATE / WEATHER / TEMP:

JUNE 19, 2015 PTLY SUNNY - W 70° F

DATUM:

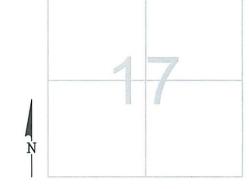

MONUMENT INFORMATION

MONUMENT TYPE: FD. 6"x8" POINTED HARDHEAD ON SURFACE - BELOW: 0.78'

LEFT - CL PAV'T - RIGHT: 2.10' (TROWBRIDGE RD.) LEFT - CL PAV'T - RIGHT: 2.25' (BILLMAN RD.)

USED POINT OF STONE.

MISC. INFORMATION

FD PK NAIL ON SURFACE, TIED W/X-TIES AND DUG FOR STONE. PLACED DRILL HOLE IN HIGH POINT OF STONE. SURFACE PK NAIL WAS 0.02'WEST AND 0.06' SOUTH OF HIGH POINT OF STONE.



JUNE 19, 2015 SET 1" SQUARE IRON PIN

IN MONUMENT BOX OVER STONE

ď SET MAG FD NAIL & NAIL IN SHINER (SIREN POLE

TROWBRIDGE RD., T.R. #67

8 FD PK BILLMAN FD FAINT NAIL "X" IN SW COR C.B.