

OTTAWA COUNTY ENGINEERS OFFICE

REFERENCE NO. 17-7-13-C
NW CORNER SECTION 17
ALLEN TWP.
SHEET 1 OF 1.

ROUTE: T-53 REIMAN RD.
@ T-67 TROWBRIDGE RD.

TOWNSHIP: ALLEN

SECTION: 17

T 7 NR 13 E.


NORTHING:

EASTING:

DATUM:

PERSONNEL:
M. WITTMAN, P.S.
J. ALLEN
S. ULLRICH

DATE / WEATHER / TEMP:
AUGUST 26, 2008
SUNNY E
74° F

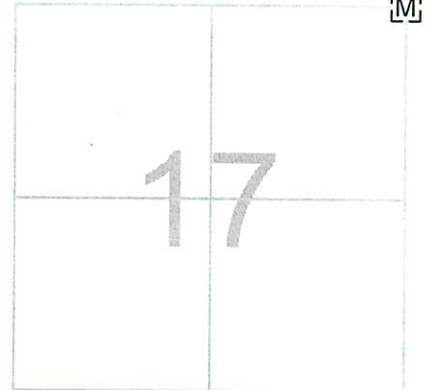

MONUMENT INFORMATION

MONUMENT TYPE: FD. 1"X 2" RECTANGULAR
IRON PIN IN MONUMENT BOX
ON SURFACE - BELOW: 0.25'
LEFT - CL PAV'T - RIGHT: 4.0' REIMAN RD.



MISC. INFORMATION


USED CENTER
OF PIN

