

# OTTAWA COUNTY ENGINEERS OFFICE

REFERENCE NO. 17-7-13-H  
SOUTH QUARTER POST SEC. 17  
ALLEN TWP.  
SHEET 1 OF 1.

ROUTE: C-66 MOLINE-MARTIN RD.

TOWNSHIP: ALLEN

SECTION: 17

T 7 NR 13 E.

**PERSONNEL:**

M. WITTMAN, P.S.  
J. ALLEN  
C. MILLER, E.KOCH  
T. RAHM, K. LENKE - GARAGE


NORTHING:

EASTING:

DATUM:

**DATE / WEATHER / TEMP:**

JULY 14, 2009  
SUNNY  
70° F

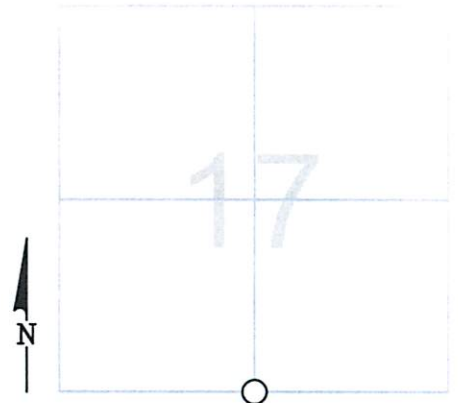

MONUMENT INFORMATION

MONUMENT TYPE: FD 1" Ø IRON PIN  
ON SURFACE - BELOW: 1.81'  
LEFT - CL PAV'T - RIGHT: 5.80'

WOOD HUB SET ON EAST SIDE OF PIN.



MISC. INFORMATION

FD. PK NAIL 0.30' BELOW SURFACE. TIED W/  
CROSS TIES AND DUG FOR IRON PIN PER  
RECORDS. PK NAIL WAS 0.09' NORTH AND 0.21'  
EAST OF IRON PIN.

JULY 14, 2009

SET 1" SQUARE IRON PIN  
IN MONUMENT BOX OVER  
1" Ø IRON PIN

