

OTTAWA COUNTY ENGINEERS OFFICE

REFERENCE NO. 18-7-13-B
NORTH QUARTER POST SEC 18
ALLEN TWP.
SHEET 1 OF 1.

ROUTE: T-67 TROWBRIDGE RD.

TOWNSHIP: ALLEN

SECTION: 18

T 7 NR 13 E.


PERSONNEL:

M. WITTMAN, P.S.
J. ALLEN
C. MILLER

NORTHING:

EASTING:

DATUM:

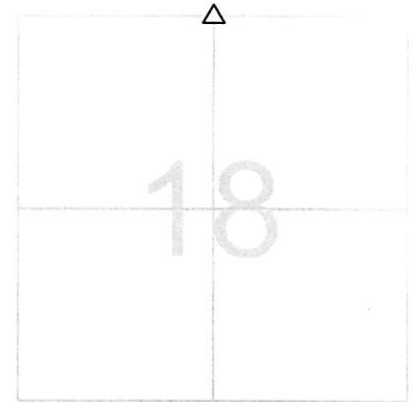

DATE / WEATHER / TEMP:

JUNE 2, 2009
OVERCAST NE
55° F

MONUMENT INFORMATION

MONUMENT TYPE: FD CRACKED LIMESTONE W/ DH
ON SURFACE - BELOW: 0.85'
LEFT - CL PAV'T - RIGHT:
RECTANGULAR STONE: 9" x 9"

USED DRILL HOLE



MISC. INFORMATION

BEC ASSOCIATES FOUND STONE AND REPORTED IT
ON APRIL 22, 2008.

JUNE 2, 2009

SET 1" SQUARE IRON PIN
IN MONUMENT BOX OVER
STONE

