

OTTAWA COUNTY ENGINEERS OFFICE

REFERENCE NO. 18-7-13-C
 NE CORNER POST SEC. 18
 ALLEN TWP.
SHEET 1 OF 1.

PERSONNEL:
 M. WITTMAN, P.S.
 J. ALLEN

DATE / WEATHER / TEMP:
 JUNE 19, 2015
 PTLY SUNNY - W
 70° F

ROUTE: T-67 TROWBRIDGE RD.
 @ T-54 BILLMAN RD.

TOWNSHIP: ALLEN


SECTION: 18

T 7 NR 13 E.

NORTHING:

EASTING:

DATUM:

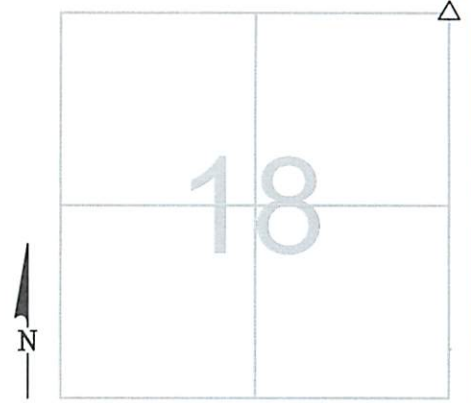

MONUMENT INFORMATION

MONUMENT TYPE: FD. 6"x8" POINTED HARDHEAD
 ON SURFACE - BELOW: 0.78'
LEFT - CL PAV'T - RIGHT: 2.10' (TROWBRIDGE RD.)
LEFT - CL PAV'T - RIGHT: 2.25' (BILLMAN RD.)
 USED POINT OF STONE.



MISC. INFORMATION

FD PK NAIL ON SURFACE, TIED W/X-TIES AND DUG
 FOR STONE. PLACED DRILL HOLE IN HIGH POINT
 OF STONE. SURFACE PK NAIL WAS 0.02' WEST
 AND 0.06' SOUTH OF HIGH POINT OF STONE.

JUNE 19, 2015

SET 1" SQUARE IRON PIN
 IN MONUMENT BOX OVER
 STONE

