

OTTAWA COUNTY ENGINEERS OFFICE

REFERENCE NO. 18-7-13-F
EAST QUARTER POST SEC. 18
ALLEN TWP.
SHEET 1 OF 1.

ROUTE: T-54 BILLMAN RD.

TOWNSHIP: ALLEN

SECTION: 18

T 7 NR 13 E.


PERSONNEL:
M. WITTMAN, P.S.
J. ALLEN

NORTHING:

EASTING:

DATE / WEATHER / TEMP:
JUN 19, 2015
OVERCAST - W
70° F

DATUM:

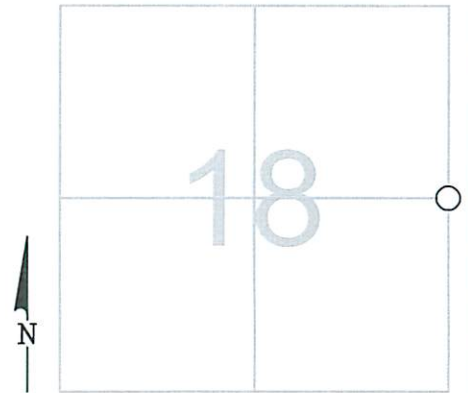

MONUMENT INFORMATION

MONUMENT TYPE: FD. 1" SQ. IRON PIN
ON SURFACE - BELOW:
LEFT - CL PAV'T - RIGHT: 9.50'



MISC. INFORMATION

1" SQUARE IRON PIN IN WEST BERM OF BILLMAN ROAD, BENT SLIGHTLY SOUTH. DROVE PIN DOWN 6" ± AND SET MONUMENT BOX OVER PIN. MONUMENT BOX 1" ± BELOW ROAD SURFACE TO AVOID BEING STRUCK BY SNOW PLOW.

JUNE 19, 2015

SET MONUMENT BOX OVER FD
1" SQUARE IRON PIN

