

OTTAWA COUNTY ENGINEERS OFFICE

REFERENCE NO. 18-7-13-I
SE CORNER POST SECTION 18
ALLEN TWP.
SHEET 1 OF 1.

ROUTE: C-66 MOLINE-MARTIN RD. @
T- 54 BILLMAN RD.

TOWNSHIP: ALLEN

SECTION: 18

T 7 NR 13 E.

PERSONNEL:

M. WITTMAN, P.S.
J. ALLEN
E. KOCH, C. MILLER
T. RAHM, K. LENKE - GARAGE


NORTHING:

EASTING:

DATE / WEATHER / TEMP:

JULY 14, 2009
SUNNY
68° F

DATUM:

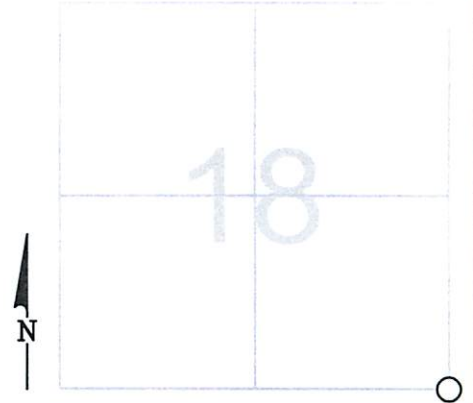


MONUMENT INFORMATION

MONUMENT TYPE: FD 1" Ø IRON PIN
ON SURFACE - BELOW: 0.35'
LEFT - CL PAVT - RIGHT: 7.90'

PER COUNTY RECORDS

SET DRILL HOLE IN CENTER OF PIN.

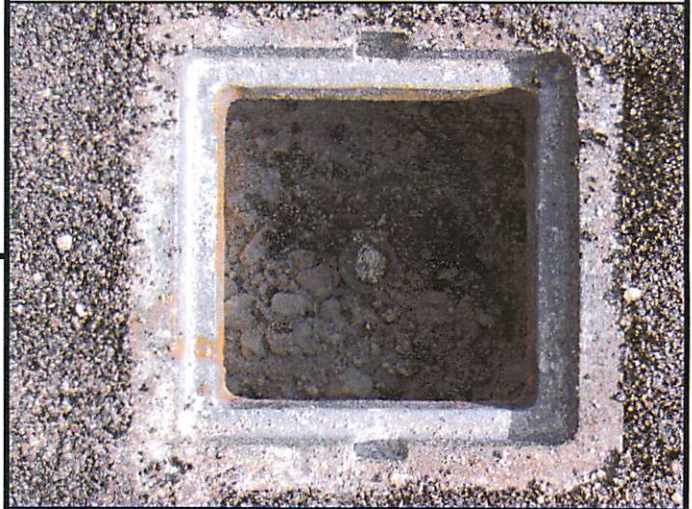

MISC. INFORMATION

FD. PK NAIL 0.02' BELOW SURFACE - PK WAS
OVER IRON PIN.

JULY 14, 2009

SET MONUMENT BOX OVER
IRON PIN

