

OTTAWA COUNTY ENGINEERS OFFICE

REFERENCE NO. 2-7-13-F
EAST QUARTER POST SEC. 2
ALLEN TWP.
SHEET 1 OF 1.

PERSONNEL:
M. WITTMAN, P.S.
J. ALLEN
K. BECK

DATE / WEATHER / TEMP:
AUGUST 9, 2010
SUNNY - S
80° F

ROUTE: T-214 OPFER LENTZ RD.

TOWNSHIP: ALLEN


SECTION: 2

T 7 NR 13 E.

NORTHING:

EASTING:

DATUM:

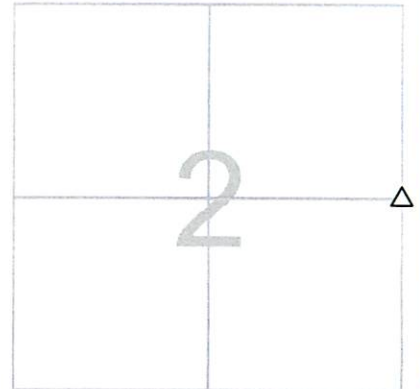

MONUMENT INFORMATION

MONUMENT TYPE: FD. 6" x 6" POINTED HARDHEAD
ON SURFACE - BELOW: 1.08'
LEFT - CL PAV'T - RIGHT: 3.00'

STONE HAD FAINT DRILL HOLE

USED DRILL HOLE



MISC. INFORMATION

FD. IRON BOLT ON SURFACE PER COUNTY
RECORDS. TIED BOLT DOWN WITH X-TIES AND DUG
FOR STONE. IRON BOLT WAS 0.11' WEST AND 0.11'
NORTH OF DRILL HOLE IN STONE.

AUGUST 9, 2010

SET 1" SQUARE IRON PIN
IN MONUMENT BOX OVER
STONE

