

OTTAWA COUNTY ENGINEERS OFFICE

REFERENCE NO. 2-7-13-H
SOUTH QUARTER POST SEC. 2
ALLEN TWP.
SHEET 1 OF 1.

ROUTE: T-68 WALBRIDGE EAST RD.

TOWNSHIP: ALLEN

SECTION: 2

T 7 NR 13 E.


PERSONNEL:
M. WITTMAN, P.S.
J. ALLEN
K. BECK

NORTHING:

EASTING:

DATUM:

DATE / WEATHER / TEMP:
AUGUST 6, 2010
SUNNY
72° F

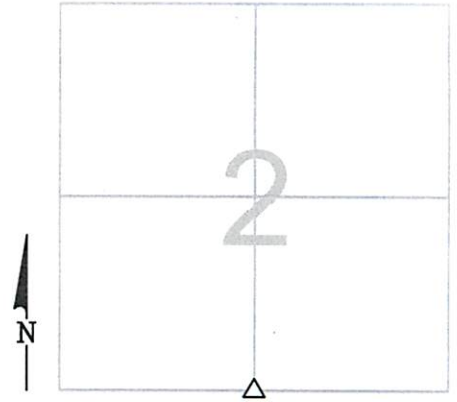

MONUMENT INFORMATION

MONUMENT TYPE: FD. 7" x 10" STONE
ON SURFACE - BELOW: 1.07'
LEFT - CL PAV'T - RIGHT: 3.20'

DRILL HOLE IN STONE

USED DRILL HOLE



MISC. INFORMATION

AUGUST 6, 2010

SET 1" SQUARE IRON PIN
IN MONUMENT BOX OVER
STONE

