

OTTAWA COUNTY ENGINEERS OFFICE

REFERENCE NO. 26-8-13-H
 SOUTH QUARTER POST SEC. 26
 ALLEN TWP.
 SHEET 1 OF 1.

ROUTE: T-70 CURTICE E & W RD.

TOWNSHIP: ALLEN

SECTION: 26

T 8 NR 13 E.


PERSONNEL:

M. WITTMAN, P.S.
 J. ALLEN
 M. ULLRICH
 S. ULLRICH

NORTHING:

EASTING:

DATUM:

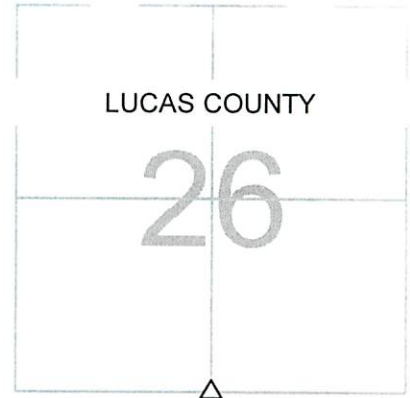

DATE / WEATHER / TEMP:

SEPTEMBER 11, 2008
 SUNNY S
 70° F

MONUMENT INFORMATION

MONUMENT TYPE: FD. 6"X9" HARDHEAD STONE
 W/ SHALLOW DRILL HOLE
 ON SURFACE - BELOW: 3.84'
LEFT - CL PAV'T - RIGHT: 1.0'
 FD. 1" SQUARE STAKE ON EAST SIDE OF STONE



MISC. INFORMATION

SET 4 EACH 3.0' PK NAIL TIES ON SURFACE
 BACKFILLED HOLE TO WITHIN 7 1/2" OF SURFACE
 WITH 411'S, TAMPED IN 6" LIFTS. SET 1"
 SQUARE IRON PIN WITH STRINGED TIES. USING
 OPTICAL TRIBRACH SET MONUMENT BOX OVER
 PIN.

SEPTEMBER 11, 2008

SET 1" SQUARE IRON PIN
 IN MONUMENT BOX OVER
 STONE

SET CHISELED "X"
 ON NORTH END OF PIPE

