

# OTTAWA COUNTY ENGINEERS OFFICE

REFERENCE NO. 28-8-13-B  
NORTH QUARTER POST SEC. 28  
ALLEN TWP.  
SHEET 1 OF 1.

ROUTE: T-1041 CEDAR STREET

TOWNSHIP: ALLEN

SECTION: 28

T 8 NR 13 E.


PERSONNEL:  
M. WITTMAN, P.S.  
J. ALLEN  
S. ULLRICH

NORTHING:

EASTING:

DATUM:

DATE / WEATHER / TEMP:  
AUGUST 26, 2008  
SUNNY E  
74° F

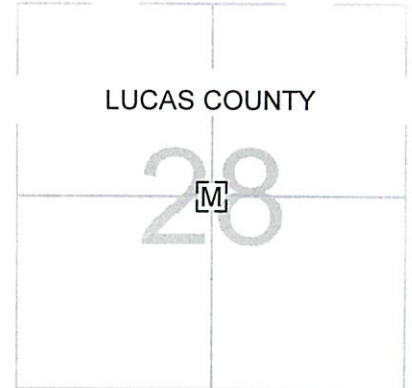

## MONUMENT INFORMATION

MONUMENT TYPE: FD 1" SQUARE IRON PIN IN  
MONUMENT BOX  
ON SURFACE - BELOW:  
LEFT - CL PAVT - RIGHT: 2.20'



## MISC. INFORMATION

