

OTTAWA COUNTY ENGINEERS OFFICE

REFERENCE NO. 28-8-13-H
SOUTH QUARTER POST SEC. 28
ALLEN TWP.
SHEET 1 OF 1.

ROUTE: C-72 WILDACRE RD.

TOWNSHIP: ALLEN
SECTION: 28

T 8 NR 13 E.


PERSONNEL:
M. WITTMAN, P.S.
J. ALLEN
S. ULLRICH

NORTHING:

EASTING:

DATUM:

DATE / WEATHER / TEMP:
AUGUST 26, 2008
SUNNY E
74° F

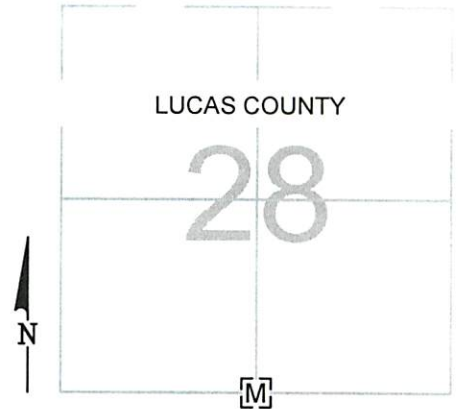

MONUMENT INFORMATION

MONUMENT TYPE: FD. 1" Ø IRON PIN IN
MONUMENT BOX
ON SURFACE - BELOW:
LEFT - CL PAV'T - RIGHT: 0.5'



MISC. INFORMATION

