

OTTAWA COUNTY ENGINEERS OFFICE


REFERENCE NO. 29-8-13-B
NORTH QUATER POST SEC. 29
ALLEN TWP.
SHEET 1 OF 1.

PERSONNEL:
M. WITTMAN, P.S.
J. ALLEN
E. KOCH
C. MILLER

DATE / WEATHER / TEMP:
FEBRUARY 4, 2010
OVERCAST
22° F

ROUTE:
TOWNSHIP: ALLEN
SECTION: 29
T 8 NR 13 E.

NORTHING:
EASTING:
DATUM:

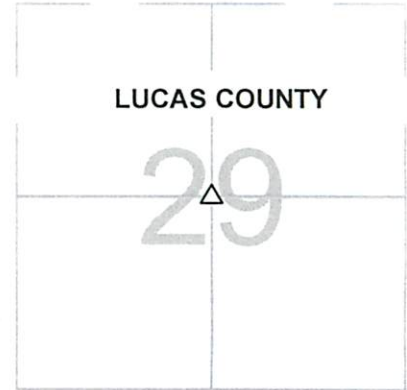

MONUMENT INFORMATION

MONUMENT TYPE: FD 6-1/2" X 6" SANDSTONE
WITH CHISLED "X" AND DRILL HOLE
ON SURFACE - BELOW:
LEFT - CL PAV'T - RIGHT:



MISC. INFORMATION

SET ORANGE DELINEATOR 1.00' EAST OF
STONE.

LUCAS COUNTY

