

OTTAWA COUNTY ENGINEERS OFFICE

REFERENCE NO. 29-8-13-H
SOUTH QUARTER POST SEC 29
ALLEN TWP.
SHEET 1 OF 1.

ROUTE: T-70 CURTICE EAST & WEST RD.

TOWNSHIP: ALLEN

SECTION: 29

T 8 NR 15 E.

PERSONNEL:

M. WITTMAN, P.S.
J. ALLEN
J. LAUBACHER


NORTHING:

EASTING:

DATUM:


DATE / WEATHER / TEMP:

JUNE 27, 2011
SUNNY SW
82° F

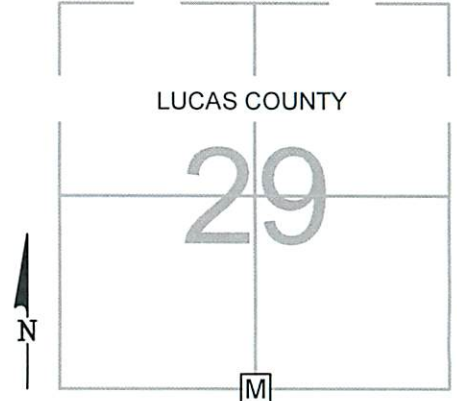

MONUMENT INFORMATION

MONUMENT TYPE: SET 1" IRON PIN IN MON BOX
ON SURFACE - BELOW:
LEFT - CL PAV'T - RIGHT: 3.00'

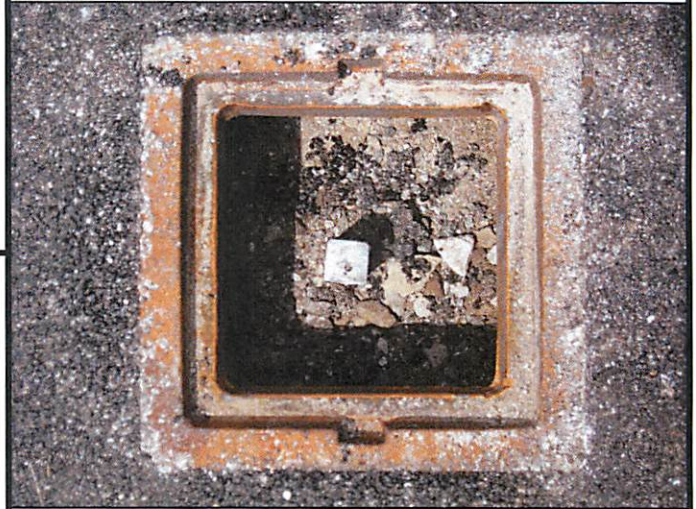

MISC. INFORMATION

SET 1" IRON PIN IN MON BOX AT CALCULATED
LOCATION PER SURVEY MADE BY THIS OFFICE
DURING FEBRUARY - MARCH 2010.

JUNE 27, 2011

SET 1" SQUARE IRON PIN
IN MONUMENT BOX

