

OTTAWA COUNTY ENGINEERS OFFICE

REFERENCE NO. 3-7-13-F
EAST QUARTER POST SEC. 3
ALLEN TWP.
SHEET 1 OF 1.

ROUTE: T-7 MARTIN-WILLISTON RD.

TOWNSHIP: ALLEN

SECTION: 3

T 7 NR 13 E.


PERSONNEL:

M. WITTMAN, P.S.
J. ALLEN
V. SZABO
N. ROSE

NORTHING:

EASTING:

DATUM:

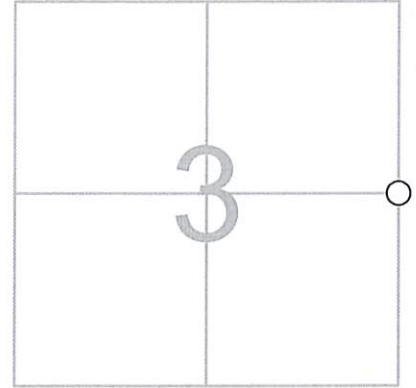

DATE / WEATHER / TEMP:

JULY 18, 2024
SUNNY - N NE
68° F

MONUMENT INFORMATION

MONUMENT TYPE: FD. 5/8" Ø IRON PIN
ON SURFACE - BELOW:
LEFT - CL PAV'T - RIGHT: 1.20'



MISC. INFORMATION

FD 5/8" Ø IRON PIN AT SURFACE, SHOT W/ GPS AND DUG FOR MORE EVIDENCE. 5/8" Ø IRON PIN WAS SOLID AT 1 FOOT DOWN, AND NO EVIDENCE OF ANYTHING ELSE WAS FOUND AND IRON PIN MATCHED SURVEY DATA OF RECORD. CUT TOP 3" OFF IRON PIN AND SET MONUMENT BOX OVER IRON.

JULY 18, 2024

SET MONUMENT BOX OVER
5/8" Ø IRON PIN

