

# OTTAWA COUNTY ENGINEERS OFFICE

REFERENCE NO. 3-7-13-H  
SOUTH QUARTER POST SEC. 3  
ALLEN TWP.  
SHEET 1 OF 1.

ROUTE: T-68 WALBRIDGE EAST RD.

TOWNSHIP: ALLEN

SECTION: 3

T 7 NR 13 E.

**PERSONNEL:**

M. WITTMAN, P.S.  
J. ALLEN, V. SZABO  
J. DUSSEAU, M. HEINTZ  
T. MARQUETTE


NORTHING:

EASTING:

**DATE / WEATHER / TEMP:**

JUNE 16, 2025  
SUNNY  
70° F - HUMID

DATUM:

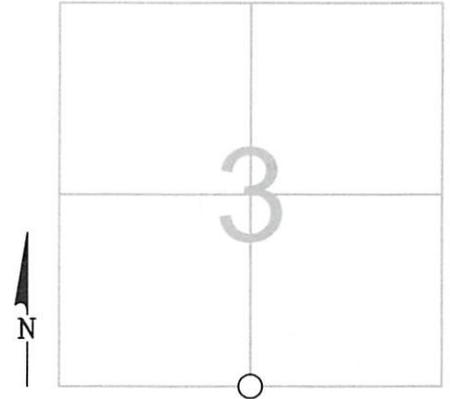

MONUMENT INFORMATION

MONUMENT TYPE: FD. 1-1/2" Ø IRON PIN  
ON SURFACE - BELOW: 0.48'  
LEFT - CL PAV'T - RIGHT: 4.30'



MISC. INFORMATION

IRON PIN IS OVER A 36" RCP CROSS-OVER UNDER  
WALBRIDGE EAST ROAD. CROSS-OVER WAS  
REPLACED IN OCTOBER 1983. THE CURRENT PIN  
WAS RESET BY P. BELL, P.E., P.S., G. FARROW AND  
M. BROUGH OF THIS OFFICE ON JUNE 26, 1984. SEE  
ALLEN TOWNSHIP 1972 FIELD BOOK PAGE 73.

JUNE 16, 2025

SET MONUMENT BOX OVER  
FD. 1-1/2" Ø IRON PIN

