

# OTTAWA COUNTY ENGINEERS OFFICE


**REFERENCE NO.** 30-8-13-G  
 SW CORNER POST SECTION 30  
 ALLEN TWP.  
**SHEET** 1 OF 1.

**ROUTE:** C-2 FOSTORIA RD. @  
 T-70 CURTICE E & W RD.  
**TOWNSHIP:** ALLEN

**SECTION:** 30  
**T** 8 **NR** 13 **E.**

**PERSONNEL:**  
 M. WITTMAN, P.S.  
 J. ALLEN  
 M. ULLRICH  
 S. ULLRICH

**NORTHING:**  
**EASTING:**  
**DATUM:**

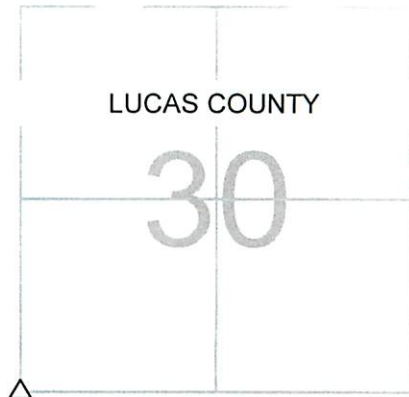

**DATE / WEATHER / TEMP:**  
 SEPTEMBER 8, 2008  
 SUNNY E-SE  
 70° F

### MONUMENT INFORMATION

MONUMENT TYPE: FD 6"X9" TRIANGULAR STONE  
 W/ DRILL HOLE  
 ON SURFACE - BELOW: 1.10'  
 21.4' TO WEST EDGE PAVEMENT



### MISC. INFORMATION

9-8-08: FD. 2" O.D. IRON PIPE SLANTED OVER  
 STONE ON EAST SIDE - PIPE WAS NOT OVER  
 DRILL HOLE. CUT 8" OFF OF PIPE - SET 1"  
 SQUARE IRON PIN OVER DRILL HOLE IN STONE;  
 BACKFILLED TO SURFACE WITH ORIGINAL FILL.  
 NEW 411'S @ SURFACE  
 SET DELINEATOR 1.0' NW OF NEW PIN

