

# OTTAWA COUNTY ENGINEERS OFFICE

REFERENCE NO. 32-8-13-B  
NORTH QUARTER POST SEC 32  
ALLEN TWP.  
SHEET 1 OF 1.

PERSONNEL:  
M. WITTMAN, P.S.  
J. ALLEN  
J. LAUBACHER

DATE / WEATHER / TEMP:  
JUNE 27, 2011  
SUNNY SW  
82° F

ROUTE: T-70 CURTICE EAST & WEST RD.

TOWNSHIP: ALLEN


SECTION: 32

T 8 NR 15 E.

NORTHING:

EASTING:

DATUM:

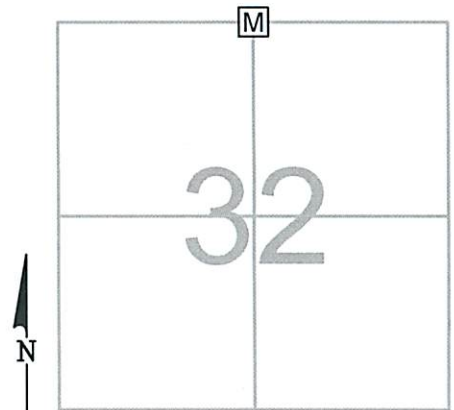

## MONUMENT INFORMATION

MONUMENT TYPE: SET 1" IRON PIN IN MON BOX  
ON SURFACE - BELOW:  
LEFT - CL PAV'T - RIGHT: 3.00'



## MISC. INFORMATION

SET 1" IRON PIN IN MON BOX AT CALCULATED  
LOCATION PER SURVEY MADE BY THIS OFFICE  
DURING FEBRUARY - MARCH 2010.

JUNE 27, 2011

SET 1" SQUARE IRON PIN  
IN MONUMENT BOX

