

OTTAWA COUNTY ENGINEERS OFFICE


REFERENCE NO. 32-8-13-I
SE CORNER POST SEC 32
ALLEN TWP.
SHEET 1 OF 1

ROUTE: T-53 REIMAN
TOWNSHIP: ALLEN
SECTION: 32
T 8 NR 13 E.

PERSONNEL:
M. WITTMAN, P.S.
J. ALLEN
J. LAUBACHER

NORTHING:
EASTING:
DATUM:

DATE / WEATHER / TEMP:
JUNE 27, 2011
SUNNY SW
82° F

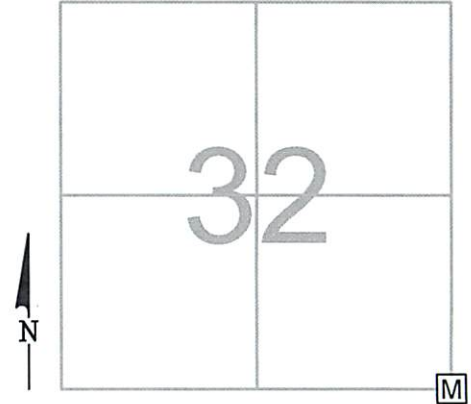

MONUMENT INFORMATION

MONUMENT TYPE: FD. RAILROAD SPIKE
ON SURFACE - BELOW: 0.24'
LEFT - CL PAV'T - RIGHT: 2.60' OF SOUTH EOP



MISC. INFORMATION

FD RR SPK FROM PRIOR SURVEYS
TIED W/ X-TIES, DUG FOR OTHER
MONUMENTATION - NONE FOUND. SET
1" SQ. IRON PIN IN MONUMENT BOX.
MON BOX IS OFF OF S. EOP @ CURVE
BOX IS BURIED IN THE BERM STONE.

JUNE 27, 2011

SET 1" SQUARE IRON PIN
IN MONUMENT BOX

