

# OTTAWA COUNTY ENGINEERS OFFICE

REFERENCE NO. 33-8-13-B  
NORTH QUARTER POST SEC. 33  
ALLEN TWP.  
SHEET 1 OF 1.

ROUTE: C-72 WILDACRE RD.

TOWNSHIP: ALLEN  
SECTION: 33

T 8 NR 13 E.


PERSONNEL:  
M. WITTMAN, P.S.  
J. ALLEN  
S. ULLRICH

NORTHING:

EASTING:

DATE / WEATHER / TEMP:  
AUGUST 26, 2008  
SUNNY E  
74° F

DATUM:

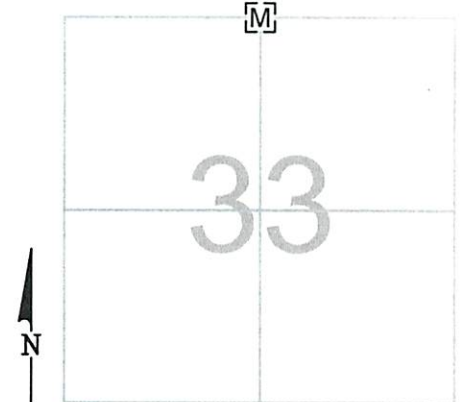

## MONUMENT INFORMATION

MONUMENT TYPE: FD. 1" Ø IRON PIN IN  
MONUMENT BOX  
ON SURFACE - BELOW:  
LEFT - CL PAV'T - RIGHT: 0.5'



## MISC. INFORMATION

