

OTTAWA COUNTY ENGINEERS OFFICE

REFERENCE NO. 34-8-13-B
 NORTH QUARTER POST SEC. 34
 ALLEN TWP.
SHEET 1 **OF** 1.

ROUTE: T-70 CURTICE E/W RD.
 @ T-268 SHORT RD.

TOWNSHIP: ALLEN

SECTION: 34

T 8 **NR** 13 **E.**


PERSONNEL:
 M. WITTMAN, P.S.
 J. ALLEN
 J. RACE
 K. TOMOR

NORTHING:

EASTING:

DATE / WEATHER / TEMP:
 MAY 31, 2023
 SUNNY
 85° F


DATUM:

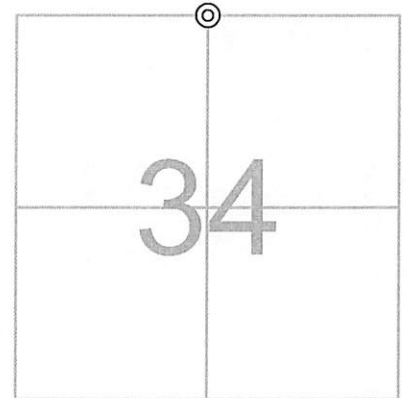

MONUMENT INFORMATION

MONUMENT TYPE: FD RR SPK IN 3/4" Ø IRON PIPE
 ON SURFACE - BELOW: 0.35'
LEFT - CL PAV'T - RIGHT: 6.05' CURTICE E/W RD
LEFT - CL PAV'T - RIGHT: 1.97' SHORT RD

 IRON PIPE IS MONUMENT OF RECORD

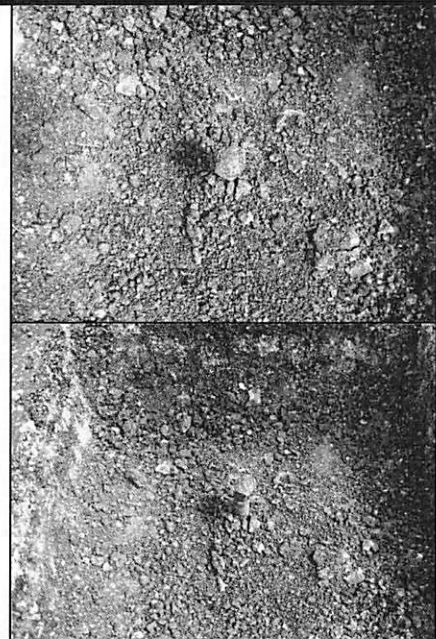

MISC. INFORMATION

FD PONY SPIKE ON SURFACE, SHOT WITH GPS AND
 DUG FOR IRON PIPE ON RECORD. FD RR SPK 0.35'
 BELOW SURFACE SHOT WITH GPS AND CONTINUED
 TO DIG FOR IRON PIPE. RR SPK WAS FOUND SET
 INSIDE OF IRON PIPE. SURFACE PONY SPIKE WAS
 0.06' WEST AND 0.17' SOUTH OF RR SPK IN PIPE.

MAY 31, 2023

SET MONUMENT BOX OVER
 RR SPK IN IRON PIPE

