

# OTTAWA COUNTY ENGINEERS OFFICE

REFERENCE NO. 34-8-13-D  
WEST QUARTER POST SEC. 34  
ALLEN TWP.  
SHEET 1 OF 1.

ROUTE: T-51 GENOA - CLAY CENTER RD.

TOWNSHIP: ALLEN

SECTION: 34

T 8 NR 13 E.

PERSONNEL:  
M. WITTMAN, P.S.  
J. ALLEN


NORTHING:

EASTING:

DATE / WEATHER / TEMP:

AUGUST 29, 2018  
SUNNY - S-SW  
83° F - HUMID

DATUM:

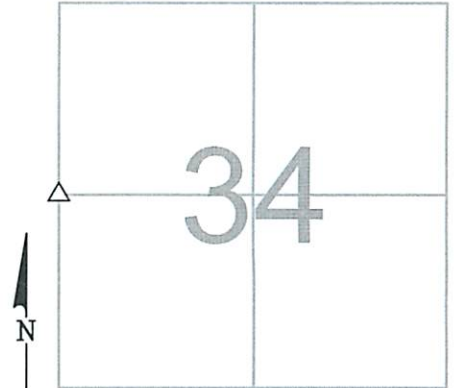

## MONUMENT INFORMATION

MONUMENT TYPE: FD. HARDHEAD STONE  
ON SURFACE - BELOW: 0.87'  
LEFT - CL PAV'T - RIGHT: 5.0'

9" x 9-1/2" IRREGULAR SHAPED HARDHEAD STONE



## MISC. INFORMATION

FD. 5/8" Ø IRON PIN AT SURFACE, TIED W/ X-TIES AND DUG FOR STONE. IRON PIN WAS DRIVEN ALONG NORTH SIDE OF STONE.

USED CENTER OF STONE.

IRON PIN WAS 0.40' NORTH AND 0.14' EAST OF POINT USED ON STONE.

AUGUST 29, 2018

SET 1" SQUARE IRON PIN  
IN MONUMENT BOX OVER  
STONE

E - W 1/2 SECTION LINE  
SECTION 33

E - W 1/2 SECTION LINE  
SECTION 34

