

OTTAWA COUNTY ENGINEERS OFFICE

REFERENCE NO. 35-8-13-F
EAST QUARTER POST SEC. 35
ALLEN TWP.
SHEET 1 OF 1.

PERSONNEL:
M. WITTMAN, P.S.
J. ALLEN
C. MILLER

DATE / WEATHER / TEMP:
APRIL 26, 2013
SUNNY - SE
50° F

ROUTE: T-214 OPFER-LENTZ RD.

TOWNSHIP: ALLEN


SECTION: 35

T 8 NR 13 E.

NORTHING:

EASTING:

DATUM:

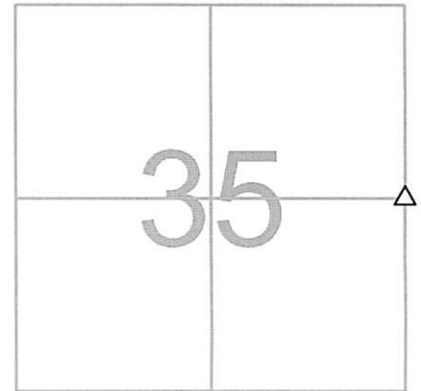

MONUMENT INFORMATION

MONUMENT TYPE: FD. 12" x 8" LIMESTONE
ON SURFACE - BELOW: 1.29'
LEFT - CL PAV'T - RIGHT: 3.65'

STONE IS 12" N/S AND 8" E/W

USED DRILL HOLE FOUND IN STONE



MISC. INFORMATION

FD. RR SPK 0.13' BELOW SURFACE, TIED W X-TIES
AND DUG FOR STONE.

RR SPK WAS 0.07' WEST OF DRILL HOLE IN STONE

MARCH 26, 2013

SET 1" SQUARE IRON PIN
IN MONUMENT BOX OVER
STONE

