

# OTTAWA COUNTY ENGINEERS OFFICE

REFERENCE NO. 35-8-13-G  
SW CORNER POST SECTION 35  
ALLEN TWP.  
SHEET 1 OF 1.

PERSONNEL:  
M. WITTMAN, P.S.  
J. ALLEN

DATE / WEATHER / TEMP:  
AUGUST 20, 2009  
SUNNY HUMID S  
78° F

ROUTE: T-7 MARTIN-WILLISTON RD. @  
S-579.

TOWNSHIP: ALLEN


SECTION: 35

T 8 N R 13 E.

NORTHING:

EASTING:

DATUM:

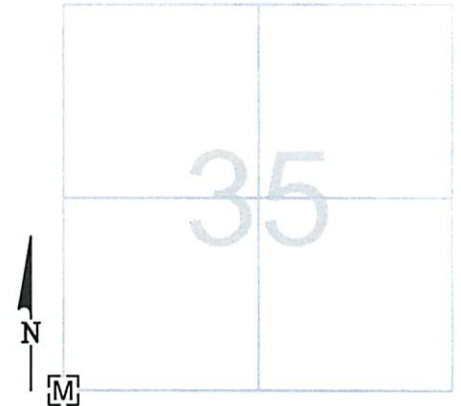

## MONUMENT INFORMATION

MONUMENT TYPE: FD 3/4" Ø IRON PIN IN MON. BOX  
ON SURFACE - BELOW:  
LEFT - CL PAV'T - RIGHT: 0.17'



## MISC. INFORMATION

